

1 FLOOR PLAN - MAIN AS-BUILT
1/8" = 1'-0"

Project Title:
**CENTRAL COUNTIES SERVICES
304 SOUTH 22ND STREET
TEMPLE, TEXAS 76501**

Drawing Title:
AS-BUILT PLAN

Drawn By: Author
Checked By: Checker
Scale: 1/8" = 1'-0"
Date: 02/06/18

THIS DRAWING AND OTHER RELATED DOCUMENTS ARE INSTRUMENTS OF MRB GROUP FOR USE SOLELY WITH RESPECT TO THIS PROJECT AND NO OTHER PROJECT. UNLESS OTHERWISE PROVIDED, THE ARCHITECT SHALL BE DEEMED THE AUTHOR OF THESE DOCUMENTS AND SHALL RETAIN ALL COMMON LAW, STATUTORY AND OTHER RESERVED RIGHTS, INCLUDING COPYRIGHTS.


MRB group
Engineering, Architecture & Surveying
5250 South 31st Street, Temple, Texas 76702 Phone: 254-771-2054
Corporate Office: The Calver Road Armory, 145 Calver Road, Suite 100, Rochester, New York 14620
Phone: 585-841-9741 Fax: 585-841-0615
www.mrbgroup.com

Sheet No.
A1.04

Project No.
2919.18002

No.	Revisions and Descriptions	By	Date

① DEMO PLAN
1/8" = 1'-0"

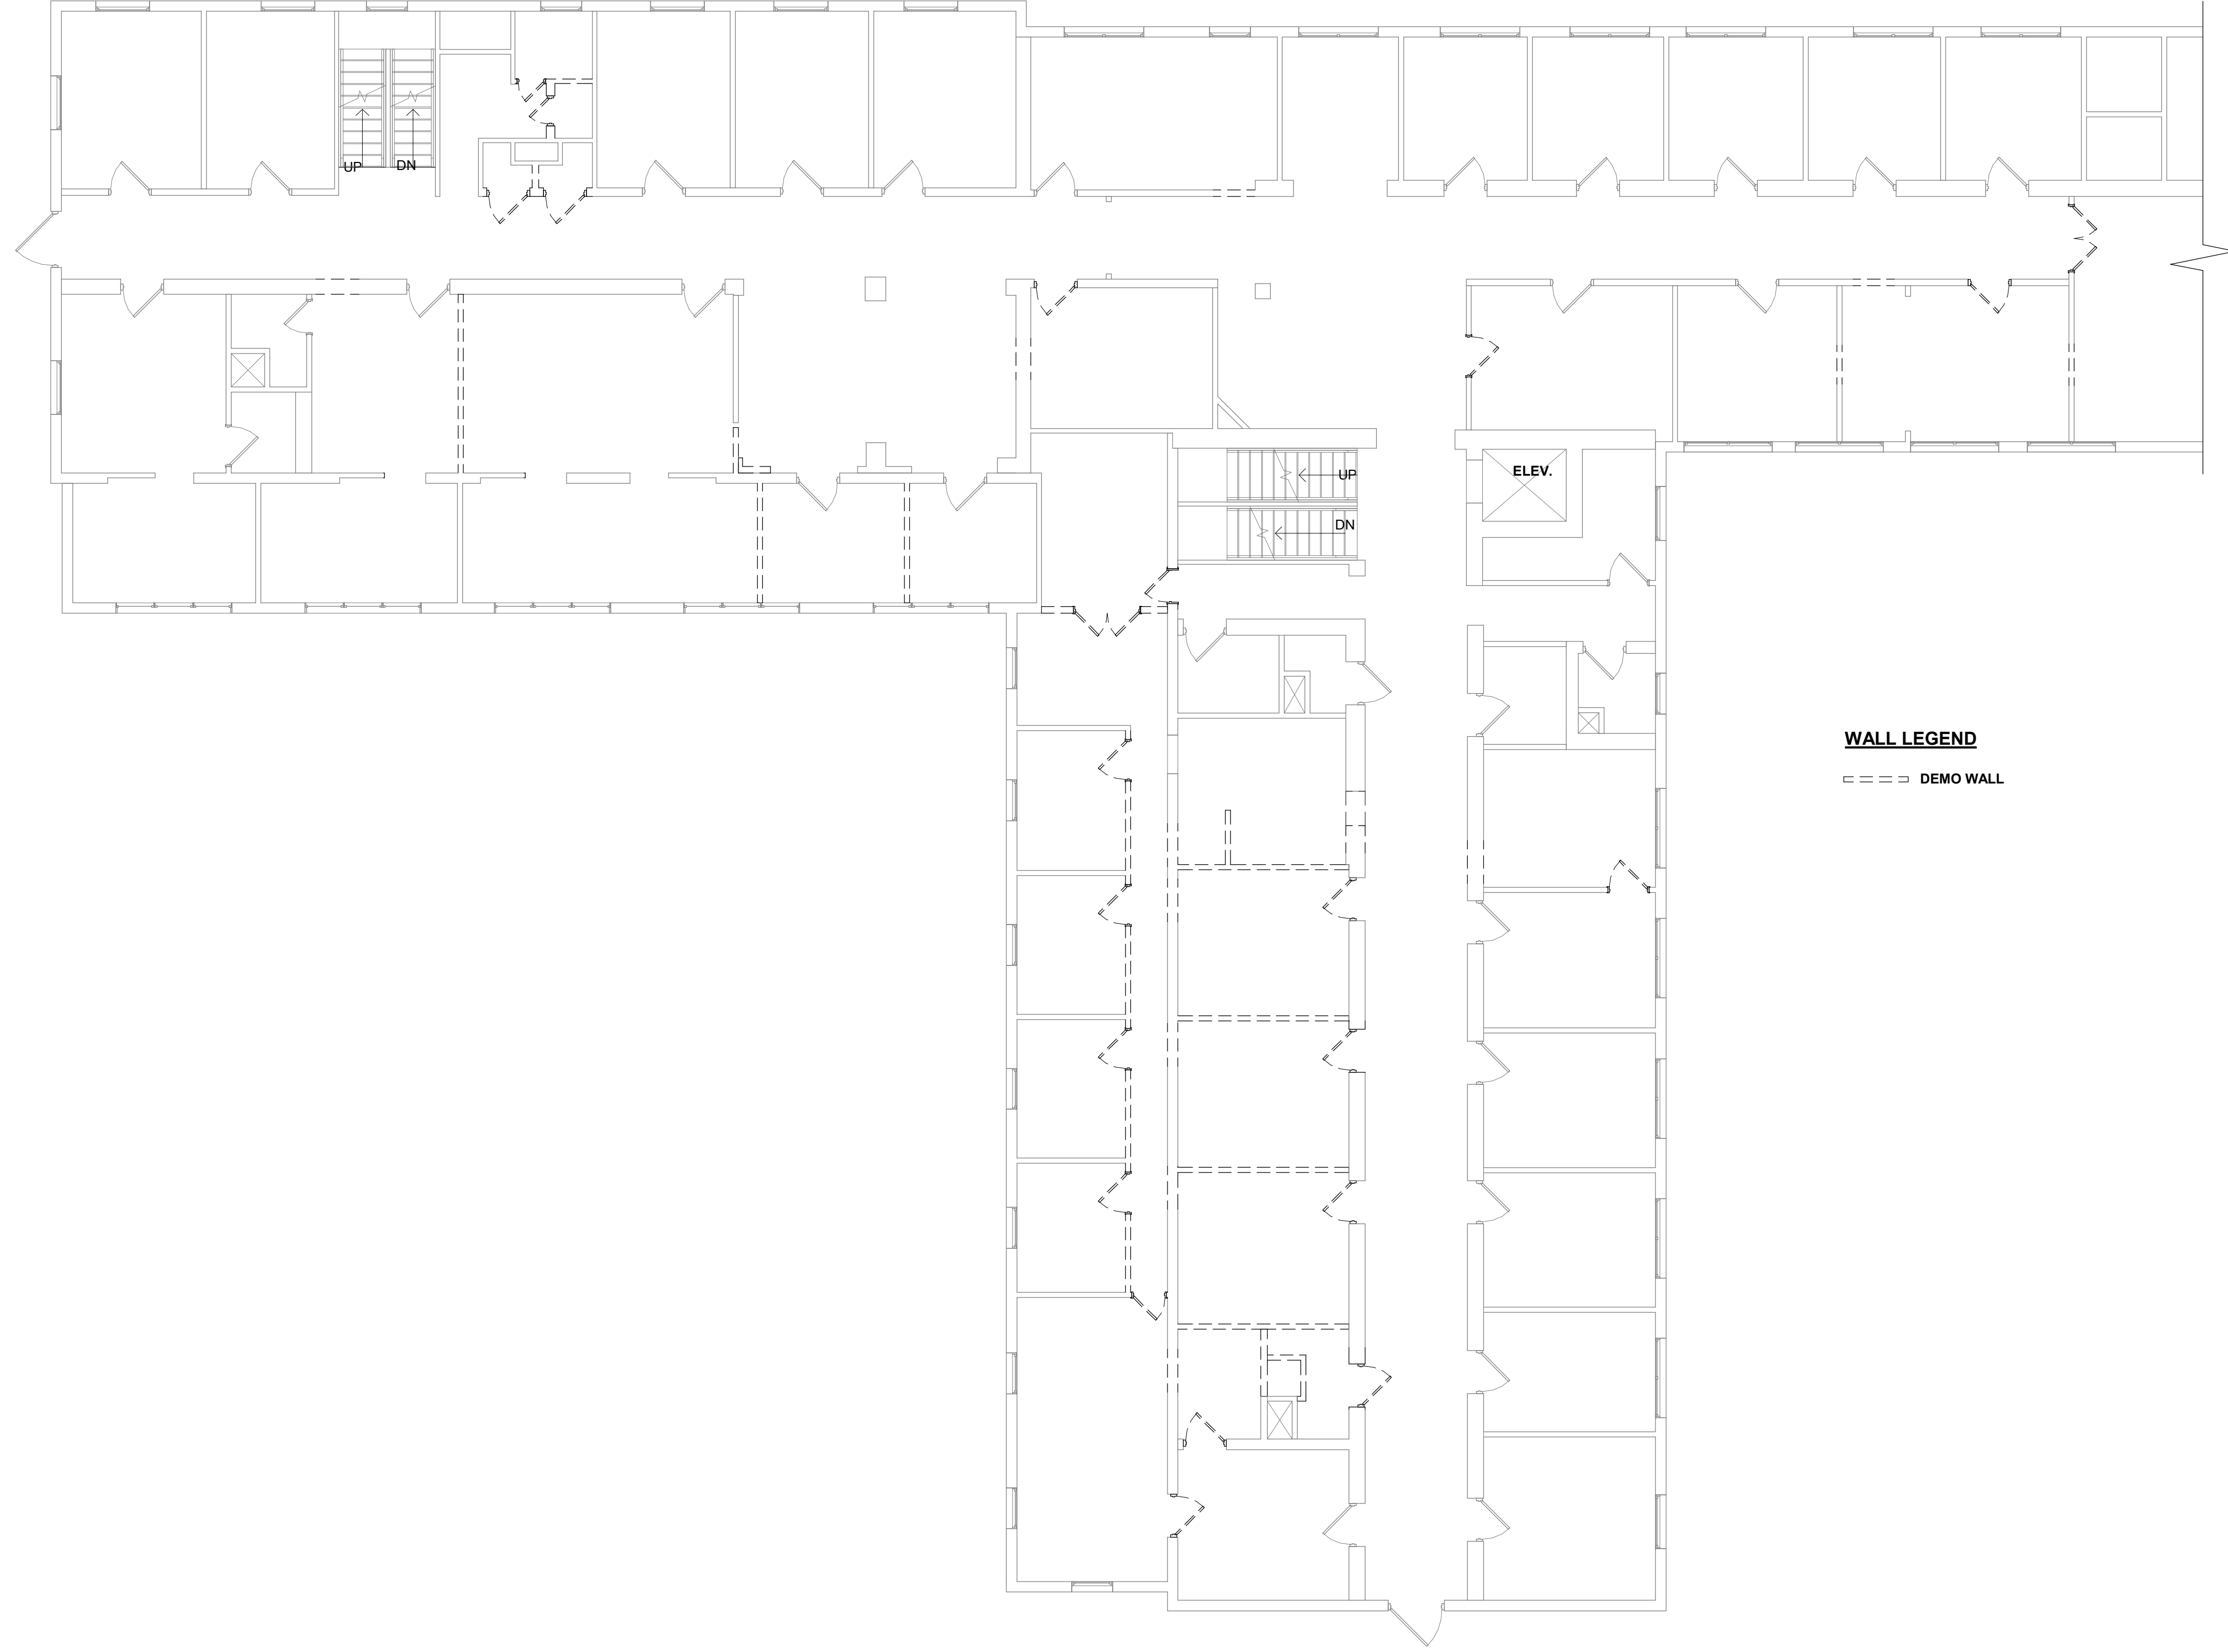

WALL LEGEND

--- DEMO WALL

Sheet No.
D1.01
of
Project No.
2919.18002

MRB group
Engineering, Architecture & Surveying
5250 South 31st Street, Temple, Texas 76702 Phone: 254-771-2054
Corporate Office: The Culver Road Annex, 145 Culver Road, Suite 100, Rochester, New York 14620
Phone: 386-841-9721 Fax: 386-841-9665
www.mrbgroup.com

THIS DRAWING AND OTHER
RELATED DOCUMENTS ARE
INSTRUMENTS OF MRB GROUP FOR
USE SOLELY WITH RESPECT TO
THIS PROJECT AND UNLESS
OTHERWISE PROVIDED, THE
ARCHITECT SHALL BE DEEMED THE
AUTHOR OF THESE DOCUMENTS
AND SHALL RETAIN ALL COMMON
LAW, STATUTORY AND OTHER
RESERVED RIGHTS, INCLUDING
COPYRIGHTS.

Drawn By: Author
Checked By: Checker
Scale: 1/8" = 1'-0"
Date: 01/01/18

Project Title:
**CENTRAL COUNTIES SERVICES
304 SOUTH 22ND STREET
TEMPLE, TEXAS 76501**
Drawing Title:
DEMOLITION PLAN

No.	Revisions and Descriptions	By	Date
Copyright © 2017 MRB Group All Rights Reserved			



WALL LEGEND

- NEW WALL
- EXISTING WALL

DEPARTMENT LEGEND

- ACT
- AMH
- BUSINESS
- CASE MANAGEMENT
- CLERK
- INTAKE

1 FLOOR PLAN - DESIGN
1/8" = 1'-0"

<p>Project Title: CENTRAL COUNTIES SERVICES 304 SOUTH 22ND STREET TEMPLE, TEXAS 76501</p>		<p>Drawing Title: SECOND FLOOR PLAN</p>
<p>Drawn By: Author</p>	<p>Checked By: Checker</p>	<p>No.: Revisions and Descriptions</p>
<p>Scale: 1/8" = 1'-0"</p>		<p>By: _____</p>
<p>Date: 01/01/18</p>		<p>Copyright: © 2017 MRB Group All Rights Reserved</p>
<p>THIS DRAWING AND OTHER RELATED DOCUMENTS ARE INSTRUMENTS OF MRB GROUP FOR USE SOLELY WITH RESPECT TO THIS PROJECT AND UNLESS OTHERWISE PROVIDED, THE ARCHITECT SHALL BE DEEMED THE AUTHOR OF THESE DOCUMENTS AND SHALL RETAIN ALL COMMON LAW STATUTORY AND OTHER RESERVED RIGHTS, INCLUDING COPYRIGHTS.</p>		
<p>MRB group Engineering, Architecture & Surveying 5250 South 31st Street, Temple, Texas 76702 Phone: 254-771-2054 Corporate Office: The Calver Road Annex, 145 Calver Road, Suite 100, Rochester, New York 14620 Phone: 585-841-9741 Fax: 585-841-0615 www.mrbgroup.com</p>		
<p>Sheet No. A1.01</p>		<p>Project No. 2919.18002</p>
<p>10/1/2016 3:12:27 PM</p>		